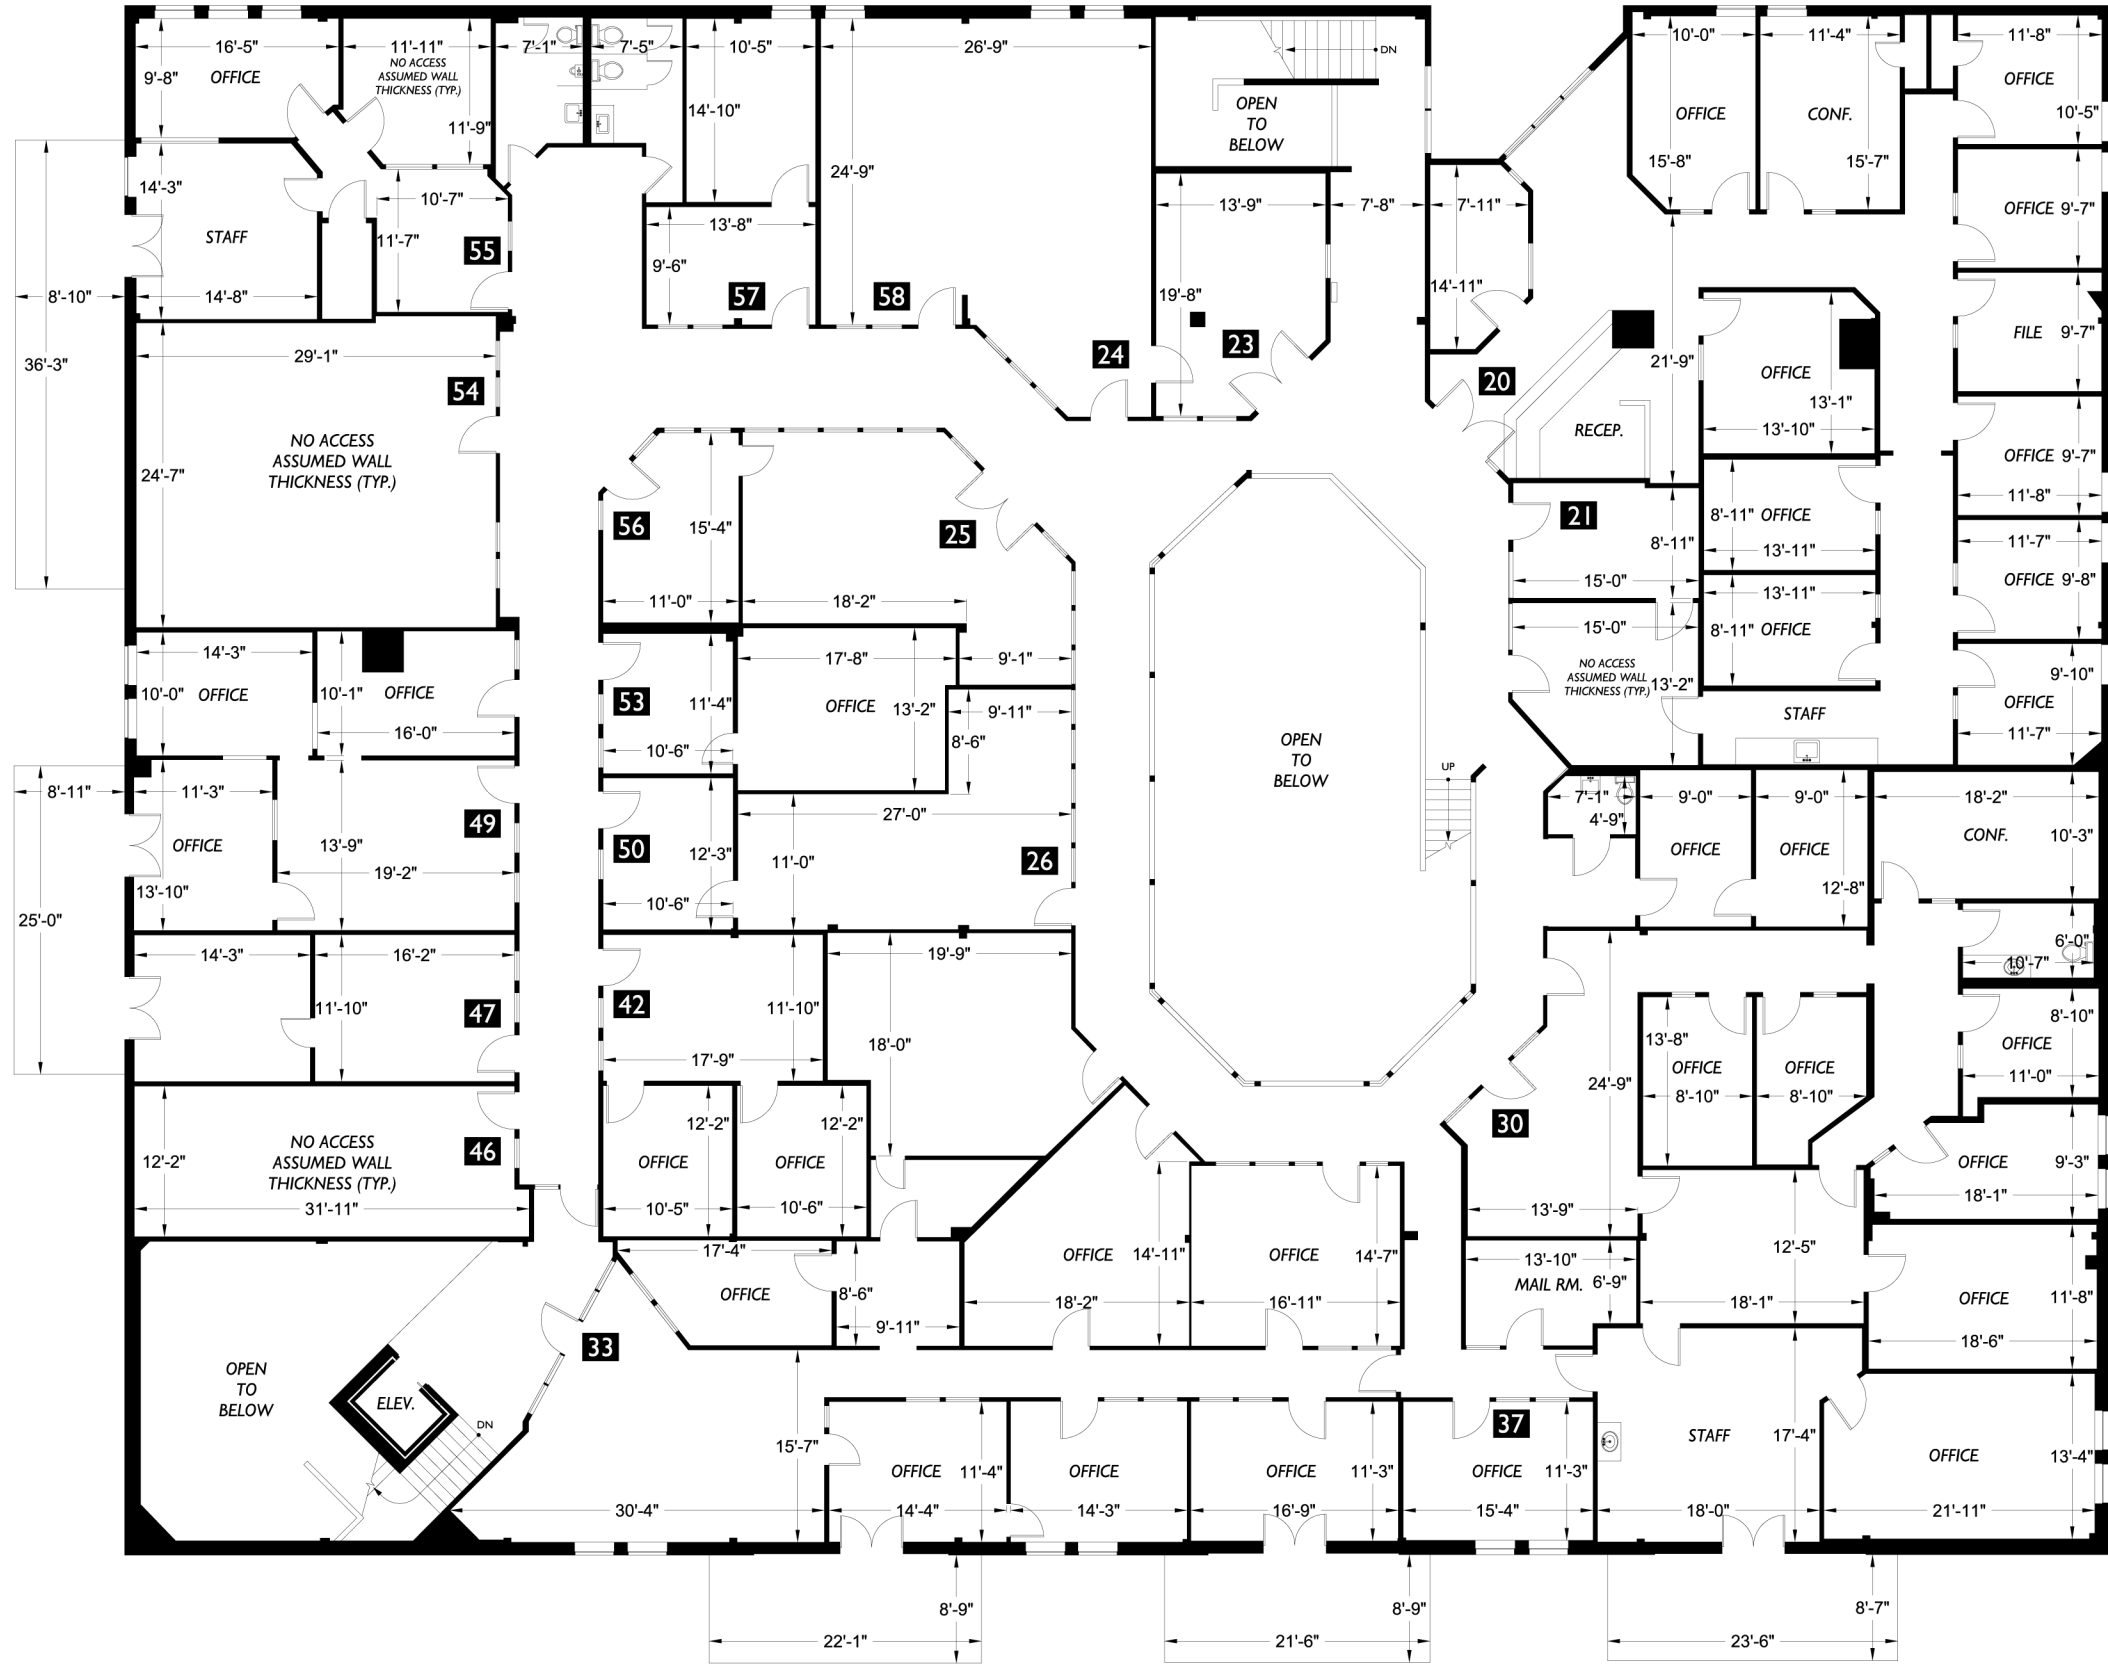


Kenco Construction
1600 SW 43rd Street Suite 200
Renton, WA 98057

Carnation Building
117 South 1st Street
Mount Vernon, WA 98273

Floor Plan

2

Floor

1/16" = 1'-0"

Scale

2-D
AS-BUILT
FLOOR PLANS

2DFLOORPLANS.COM
206-328-7410 fax 206-328-4764
1700 21st Avenue South Suite 100
Seattle, WA 98144

Measured: July 2013

Project: C13-440